

1a Foxborough Rd  
Radley  
Sub-division

Appendix 1




Enabled by Ordnance Survey

© Crown Copyright 2008. All rights reserved. Licence number 100020449 Plotted Scale - 1:1250

JPPC

Drawing 1  
May 2015

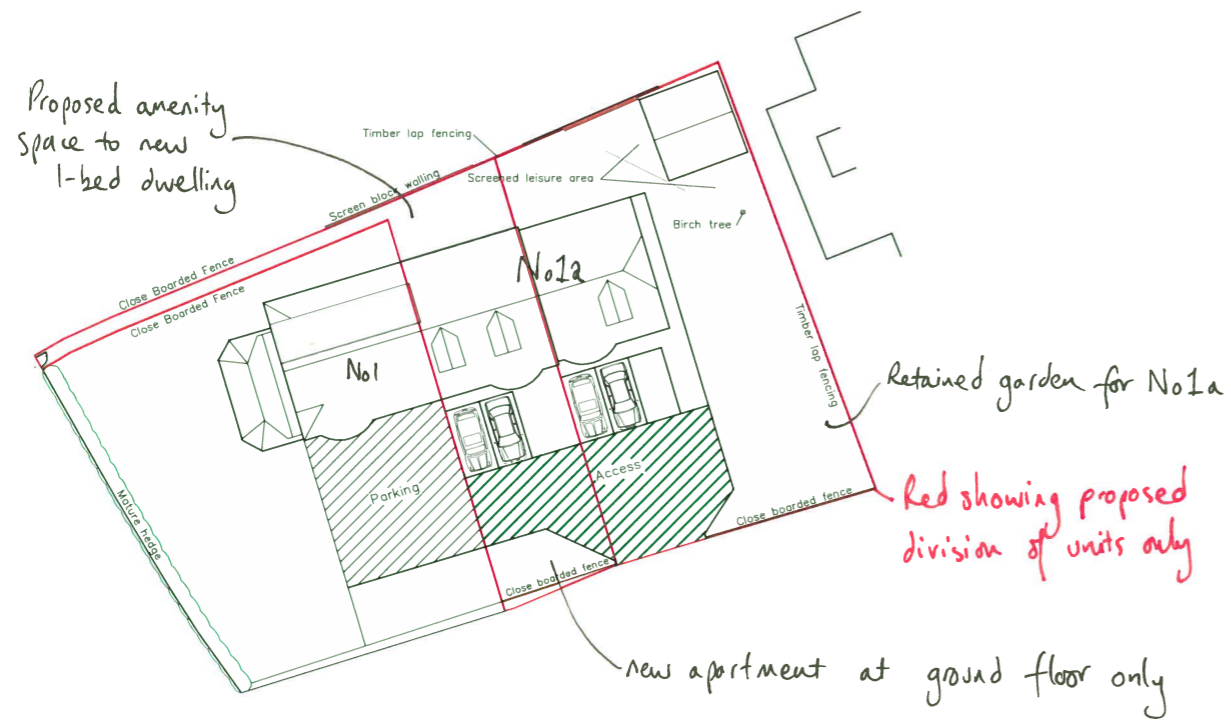

Scale 1-500



Scale 1-1250 showing division of units see Drwg 1 for red line site location



For obtaining Local Authority Approval only. Builder to check all dimensions.

Conversion of One Dwelling into Two

1a Foxborough Road  
Radley  
Oxon

J & K Partnership

Scale as shown

May 2015  
Drwg No 2




Existing South Elevation



Unit 1      ↑ New door      Unit 2

Proposed South Elevation

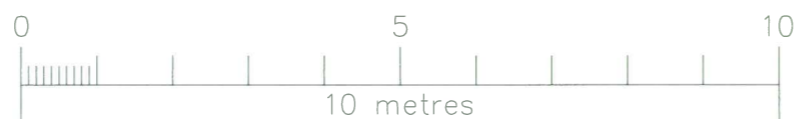

*Note no changes to other elevations*

For obtaining Local Authority Approval only. Builder to check all dimensions.


Conversion of One Dwelling into Two

1a Foxborough Road  
Radley  
Oxon


J & K Partnership

Scale 1-100


May 2015  
Drwg No 5

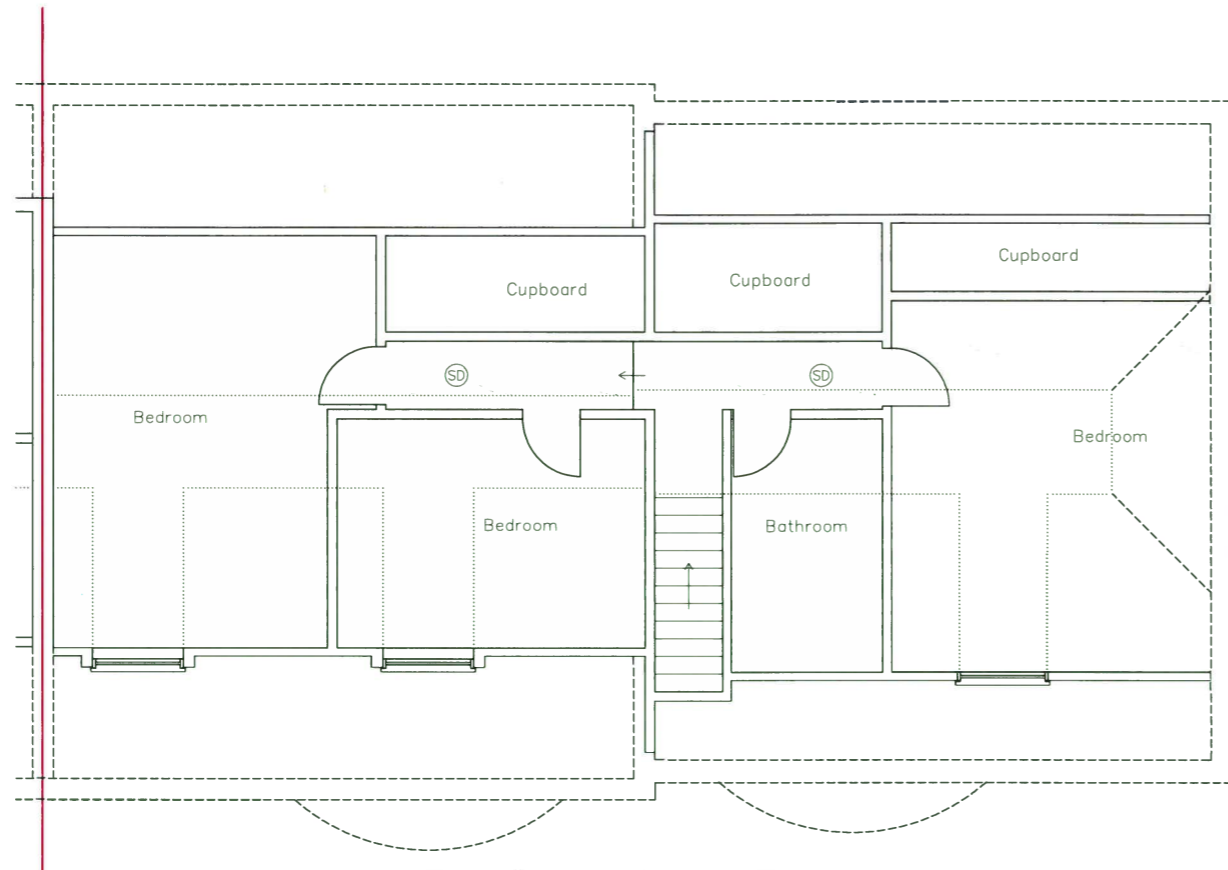

Existing First Floor

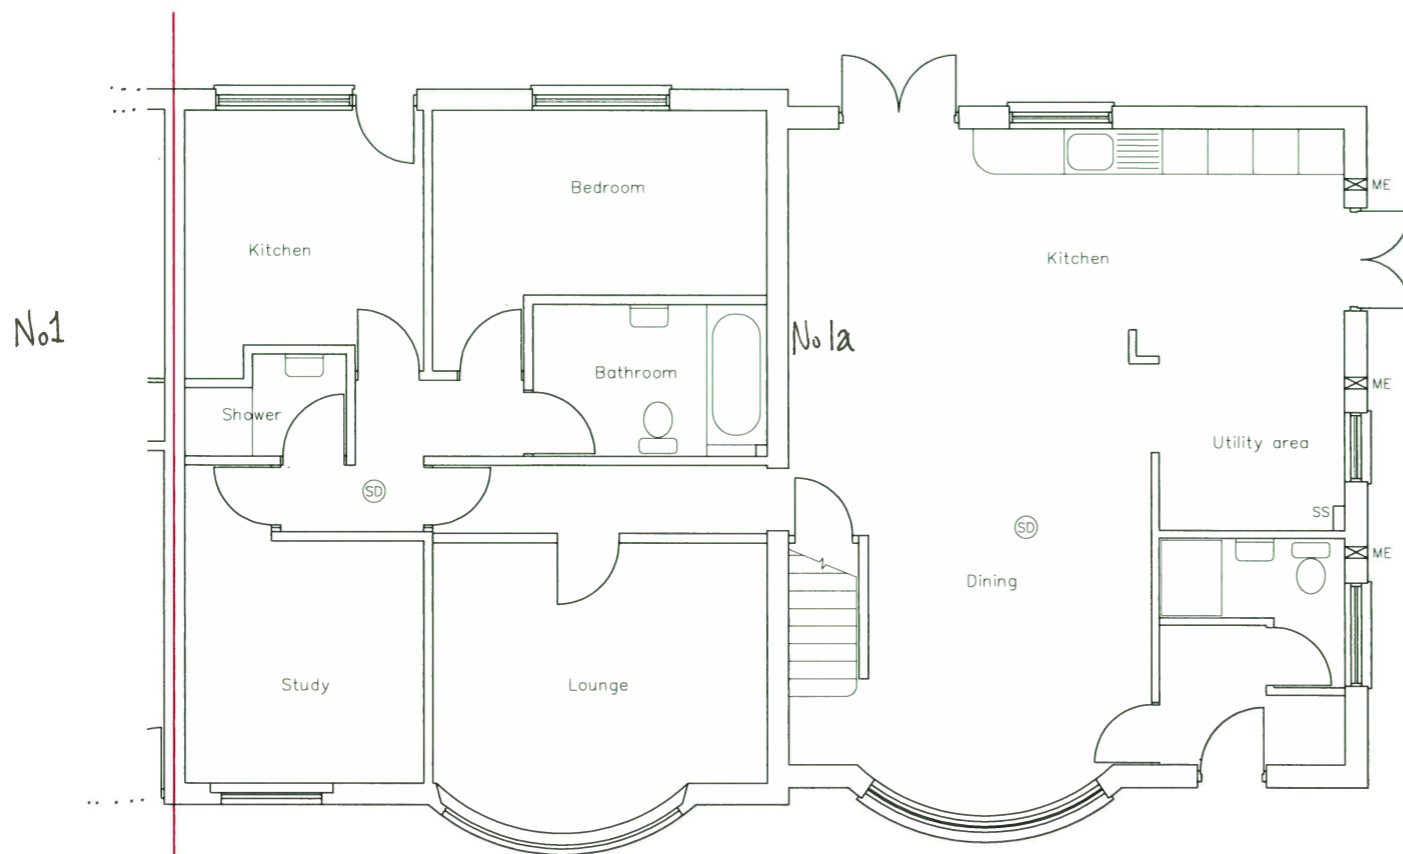

Existing Ground Floor

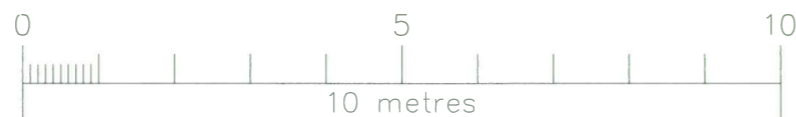

For obtaining Local Authority Approval only. Builder to check all dimensions.



Conversion of One Dwelling into Two

1a Foxborough Road  
Radley  
Oxon

J & K Partnership

Scale 1-100

May 2015  
Drwg No 3

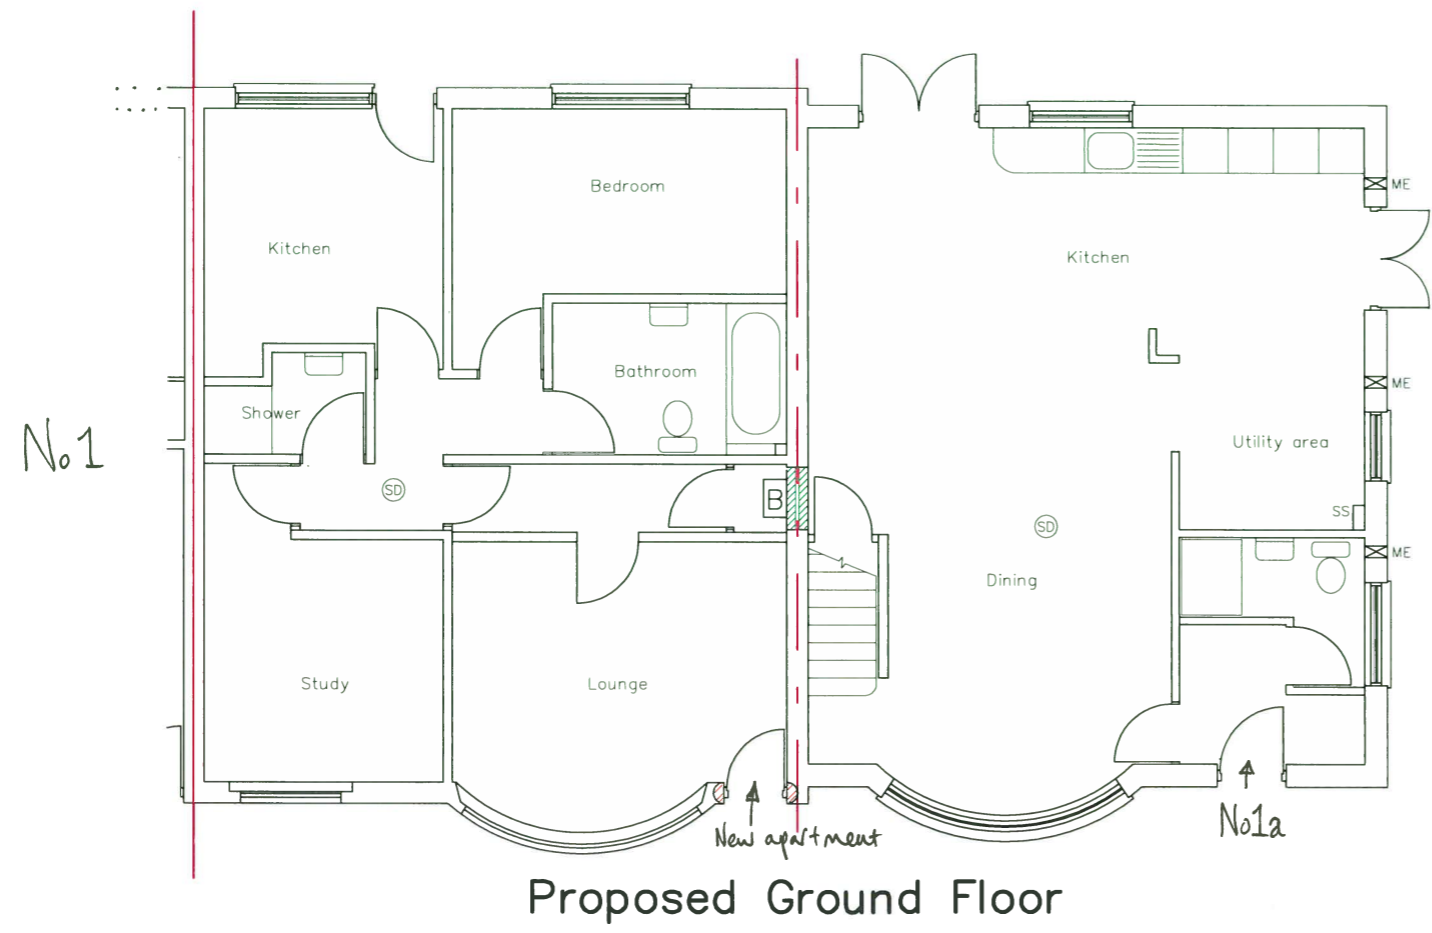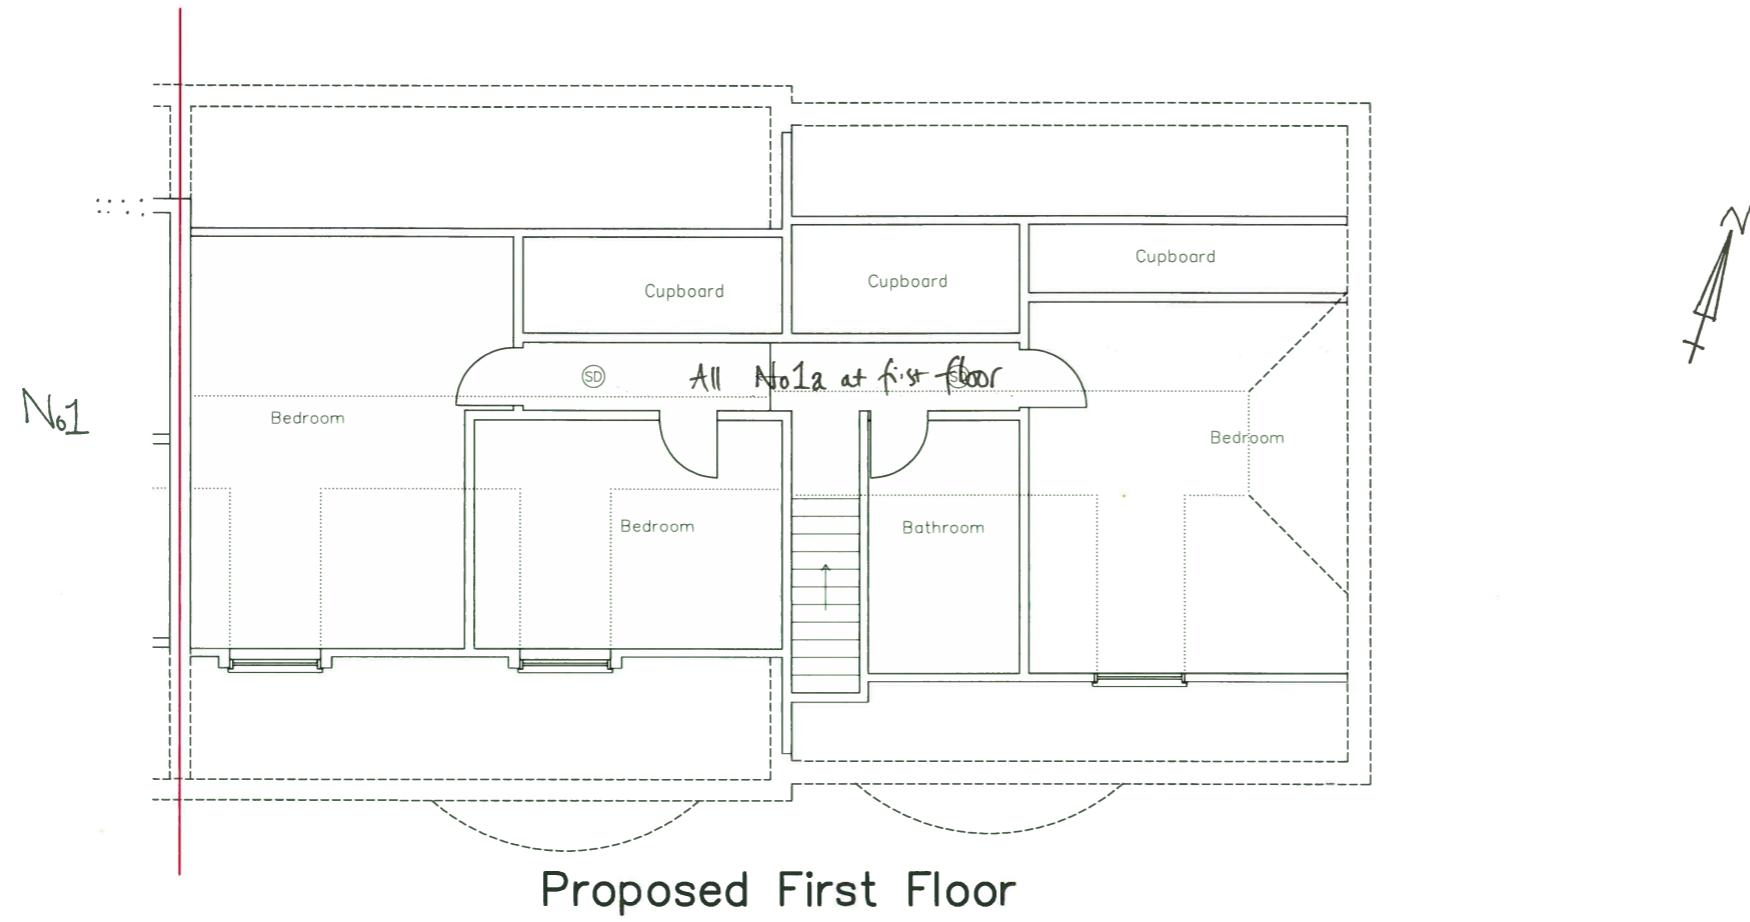

For obtaining Local Authority Approval only. Builder to check all dimensions.

Conversion of One Dwelling into Two

1a Foxborough Road  
Radley  
Oxon

J & K Partnership

Scale 1-100

May 2015  
Drwg No 4